



ROOF PLAN
1:100

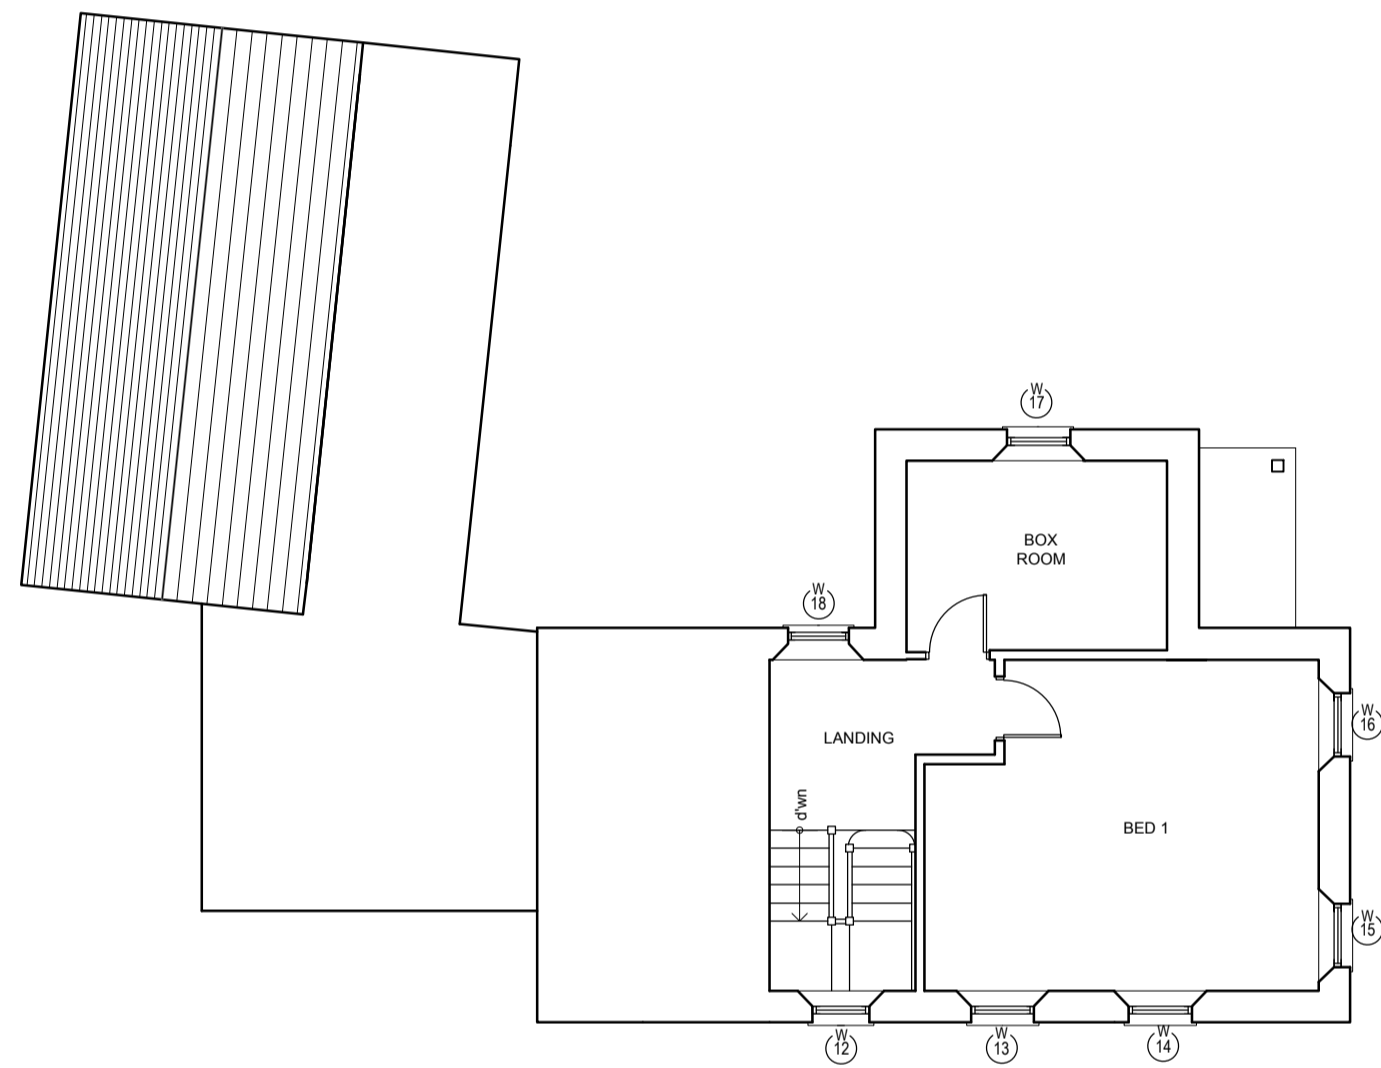


FIRST FLOOR PLAN
1:100

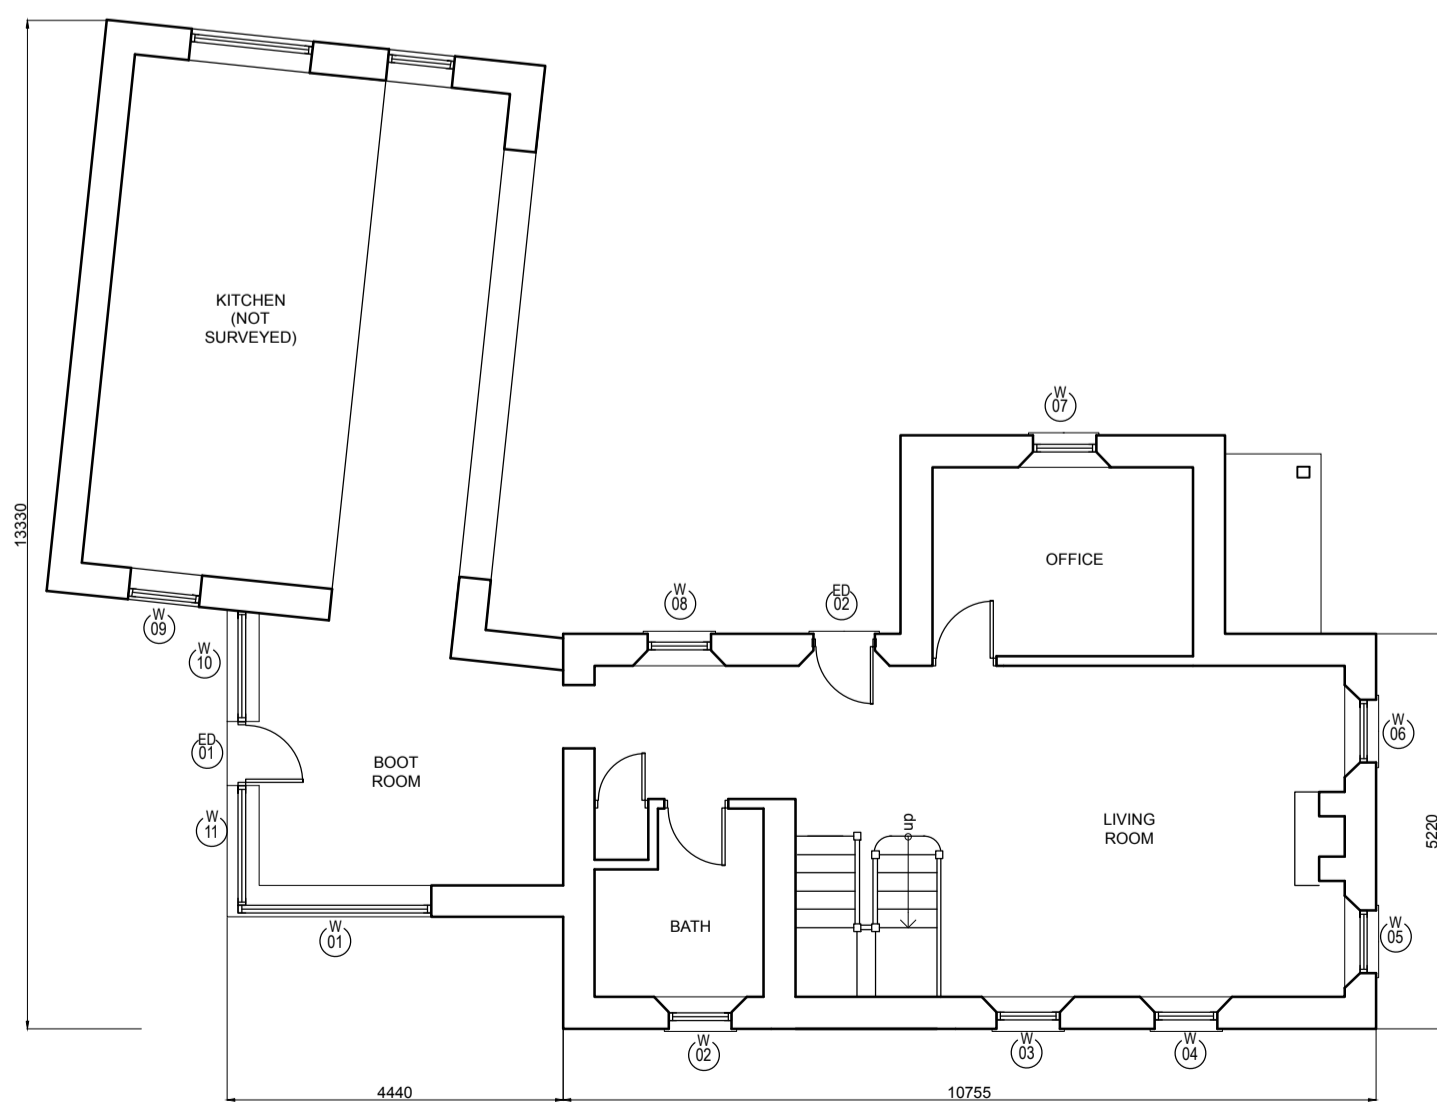

GROUND FLOOR PLAN
1:100




BLOCK PLAN
1:500

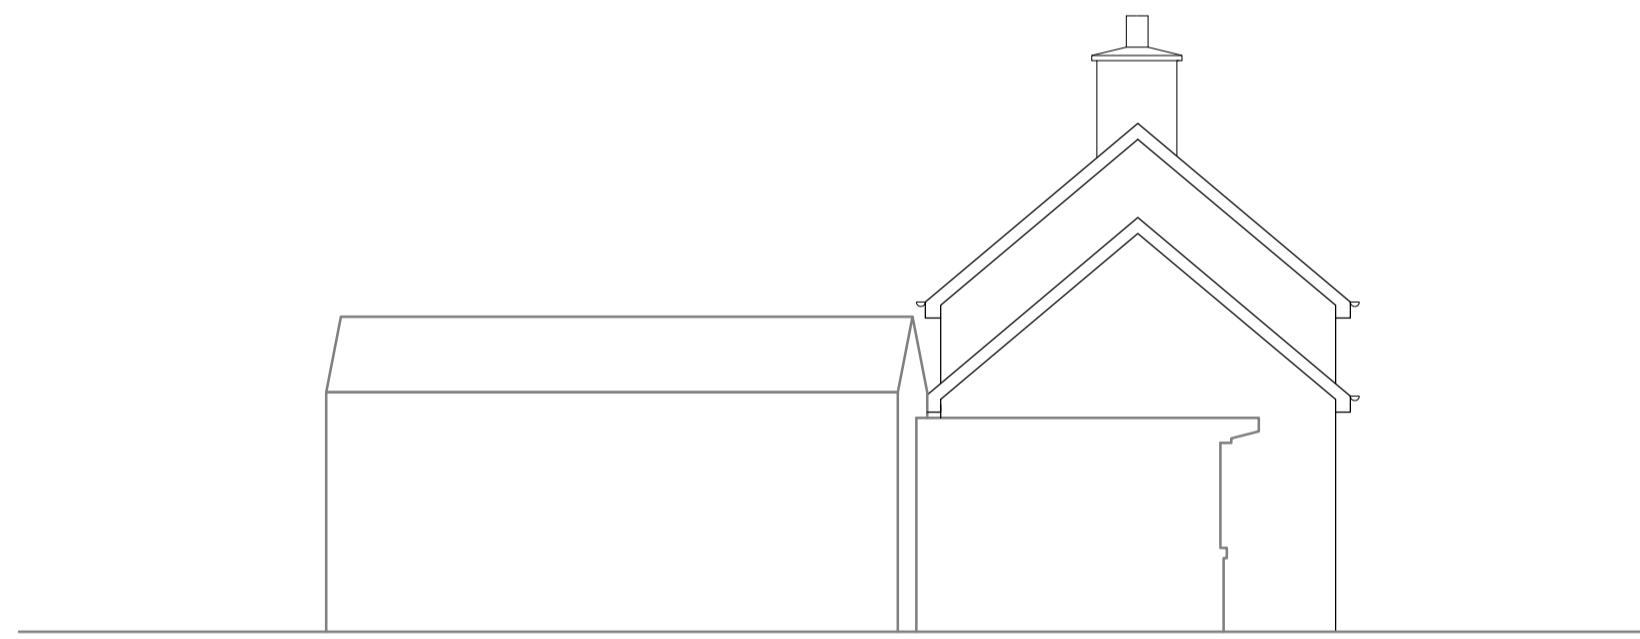

NORTH ELEVATION
1:100



SOUTH ELEVATION
1:100

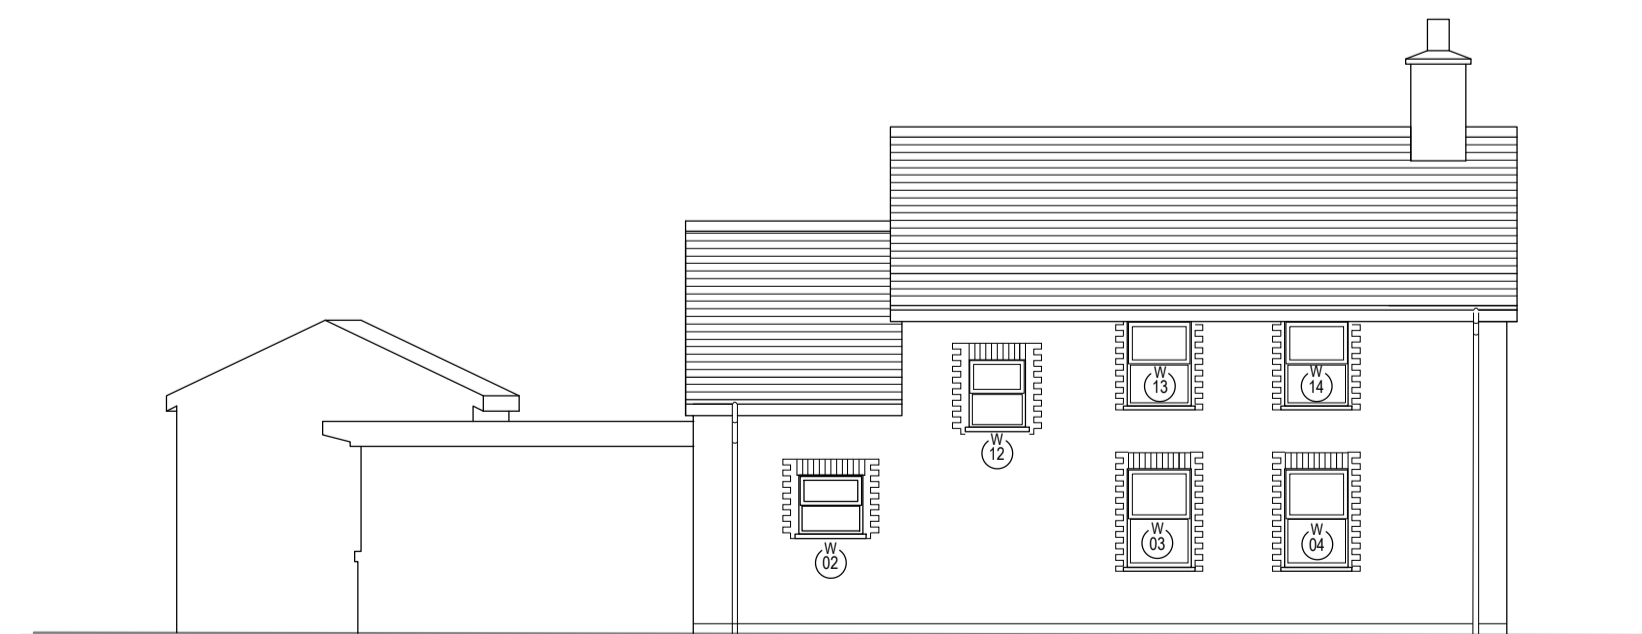

WEST ELEVATION
1:100



©Crown Copyright and database rights 2016 OS 100019980

LOCATION PLAN
1:1250



Revisions

Rev No Date Note



Catalina Architecture + Design Ltd, The Cambria,
Marine Terrace, Aberystwyth, Ceredigion, SY23 2AZ
Tel: 01970 623480
email: enquires@catalina.cymru

PROJECT
PENGEULAN

CLIENT
ELAINE + OWEN EGAN

SUBJECT
RECORD DRAWINGS

JOB NUMBER 1422 DRAWING NUMBER REC10 REVISION /

DRAWN ZS CHECKED

SCALE As shown @A1 DATE DECEMBER 2019

© This drawing and the building works depicted are the copyright of the Architect and may not be reproduced except with written consent. Do not scale off drawings. All dimensions to be carefully ascertained & checked on site prior to ordering, fabrication, manufacture, etc.